


- NOTES**
- BENCHMARK: CITY OF HAMILTON MONUMENT NO. 0772002091  
ELEVATIONS SHOWN ARE GEODETIC ORIGIN (CGVD 28) AND ARE DERIVED FROM THE CITY OF HAMILTON VERTICAL CONTROL MONUMENT NO. 0772002091. PUBLISHED ELEVATION = 140.044m  
LOCAL BENCHMARK: CUT CROSS SET IN CONCRETE CURB ON EAST SIDE OF PIRIE DRIVE, 19m NORTH OF CENTERLINE OF GOVERNOR'S ROAD. ELEVATION = 141.29m
  - BOUNDARIES & EXISTING GROUND ELEVATIONS AS SURVEYED BY J D BARNES LIMITED (FILE # 19-30-464-00-A), DATED NOV.28'19.
- LEGEND**
- x(226.00) DENOTES PROPOSED FINISHED GROUND ELEVATION
  - x(226.00)T/F DENOTES PROPOSED TOP OF FOUNDATION ELEVATION
  - x(226.00)G/L DENOTES PROPOSED GUTTER LINE ELEVATION
  - x(223.00) DENOTES EXISTING GROUND ELEVATIONS AS SURVEYED BY J D BARNES LIMITED
  - 226.50 DENOTES EXISTING GROUND CONTOUR
  - (226.00) DENOTES PROPOSED FINISHED GROUND ELEVATION AT FRONT/REAR APRON OF DWELLING
  - (S-226.00) DENOTES PROPOSED SWALE ELEVATION
  - 1/F-(219.20) DENOTES PROPOSED TOP OF FOUNDATION ELEVATION
  - ⊕ DENOTES EXISTING WATER SERVICE SHUTOFF VALVE
  - U.P. DENOTES EXISTING UTILITY POLE
  - ⊕ DENOTES EXISTING OVERHEAD WIRES
  - DENOTES PROPOSED SWALE
  - DENOTES PROPOSED DIRECTION OF DRAINAGE
  - x x x DENOTES EXIST. WIRE OR CHAINLINK FENCE
  - ⊙ DENOTES EXISTING STREET LIGHT STANDARD
  - ⊙ DENOTES PROP STREET TREE
  - R.W.L.O DENOTES PROPOSED RAINWATER LEADER DOWN PIPE
  - HYD DENOTES EXISTING FIRE HYDRANT
  - 3/11 DENOTES PROPOSED 3H:1V(MAX) SLOPE
  - DENOTES TOP OF EXISTING SLOPE
  - DENOTES PROP "HEAVY DUTY" SILT CONTROL FENCE PER OPSD 219.130
  - No.3 DENOTES EXISTING MUNICIPAL STREET ADDRESS NO.S
  - ▨ DENOTES PROP INDIVIDUAL DRIVEWAYS, (65mm HL3 ON 150mm GRAN. "A" & 200mm GRAN. "B" TYPE II STONE.)
  - ▨ DENOTES PROP HEAVY DUTY DRIVEWAY ASPHALT AREA, (40MM HL3 & 65MM HL8 ASPHALT ON 150MM GRAN "A" & 350MM GRAN "B" TYPE II STONE BASE)
  - DENOTES PROPOSED PAD-MOUNTED HYDRO TRANSFORMER.
  - ▨ DENOTES PROP LANDSCAPED AREA.
  - DENOTES MAJOR STORM OVERLAND FLOW ROUTE.
  - ▨ DENOTES PROP PRECAST CONCRETE MODULAR BLOCK RETAINING WALL, OR APPROVED EQUAL.
  - ▨ DENOTES PROP TIMBER RETAINING WALL OR APPROVED EQUAL.
  - M.B.E.-(142.95) DENOTES LOWEST ALLOWABLE DWELLING BASEMENT ELEVATION PERMITTING GRAVITY SANITARY SEWER SERVICE.

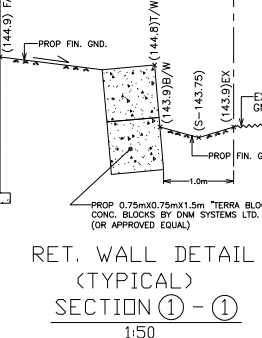

NO	DATE	BY	REVISION

SCALE: 1:250

DATE: AUGUST 2020

REF.

SEAL

LICENCED PROFESSIONAL ENGINEER  
D.P. JOYCE  
Oct. 10, 2020  
PROVINCE OF ONTARIO

CONSULTANT  
**SIDNEY W. WOODS ENGINEERING (2011) INC.**  
334 HATT ST., DUNDAS, ON L9H 2H9 (905)627-0775

MUNICIPALITY  
CITY OF HAMILTON

OWNER  
Fieldgate Properties Limited  
5400 YONGE ST., SUITE 300, TORONTO ON M2N 5R5


TITLE  
**SITE GRADING PLAN**  
TO ACCOMPANY ZBA APPLICATION ZRA-20-\_\_\_\_  
(PER FC-20-018)

PROJECT  
125 PIRIE DRIVE, DUNDAS  
PROP. 17NR BUNGALOW TOWNHOMES &  
155 UNIT 4-STOREY SENIOR'S APARTMENT BLDG.  
(LOTS 1 TO 9 INCL. & BLOCK 18 OF R.P. 62M-683)


© 2020, ALL RIGHTS RESERVED SHEET 1 OF  
SIDNEY W. WOODS ENGINEERING (2011) INC. INDEX NO. E-1338





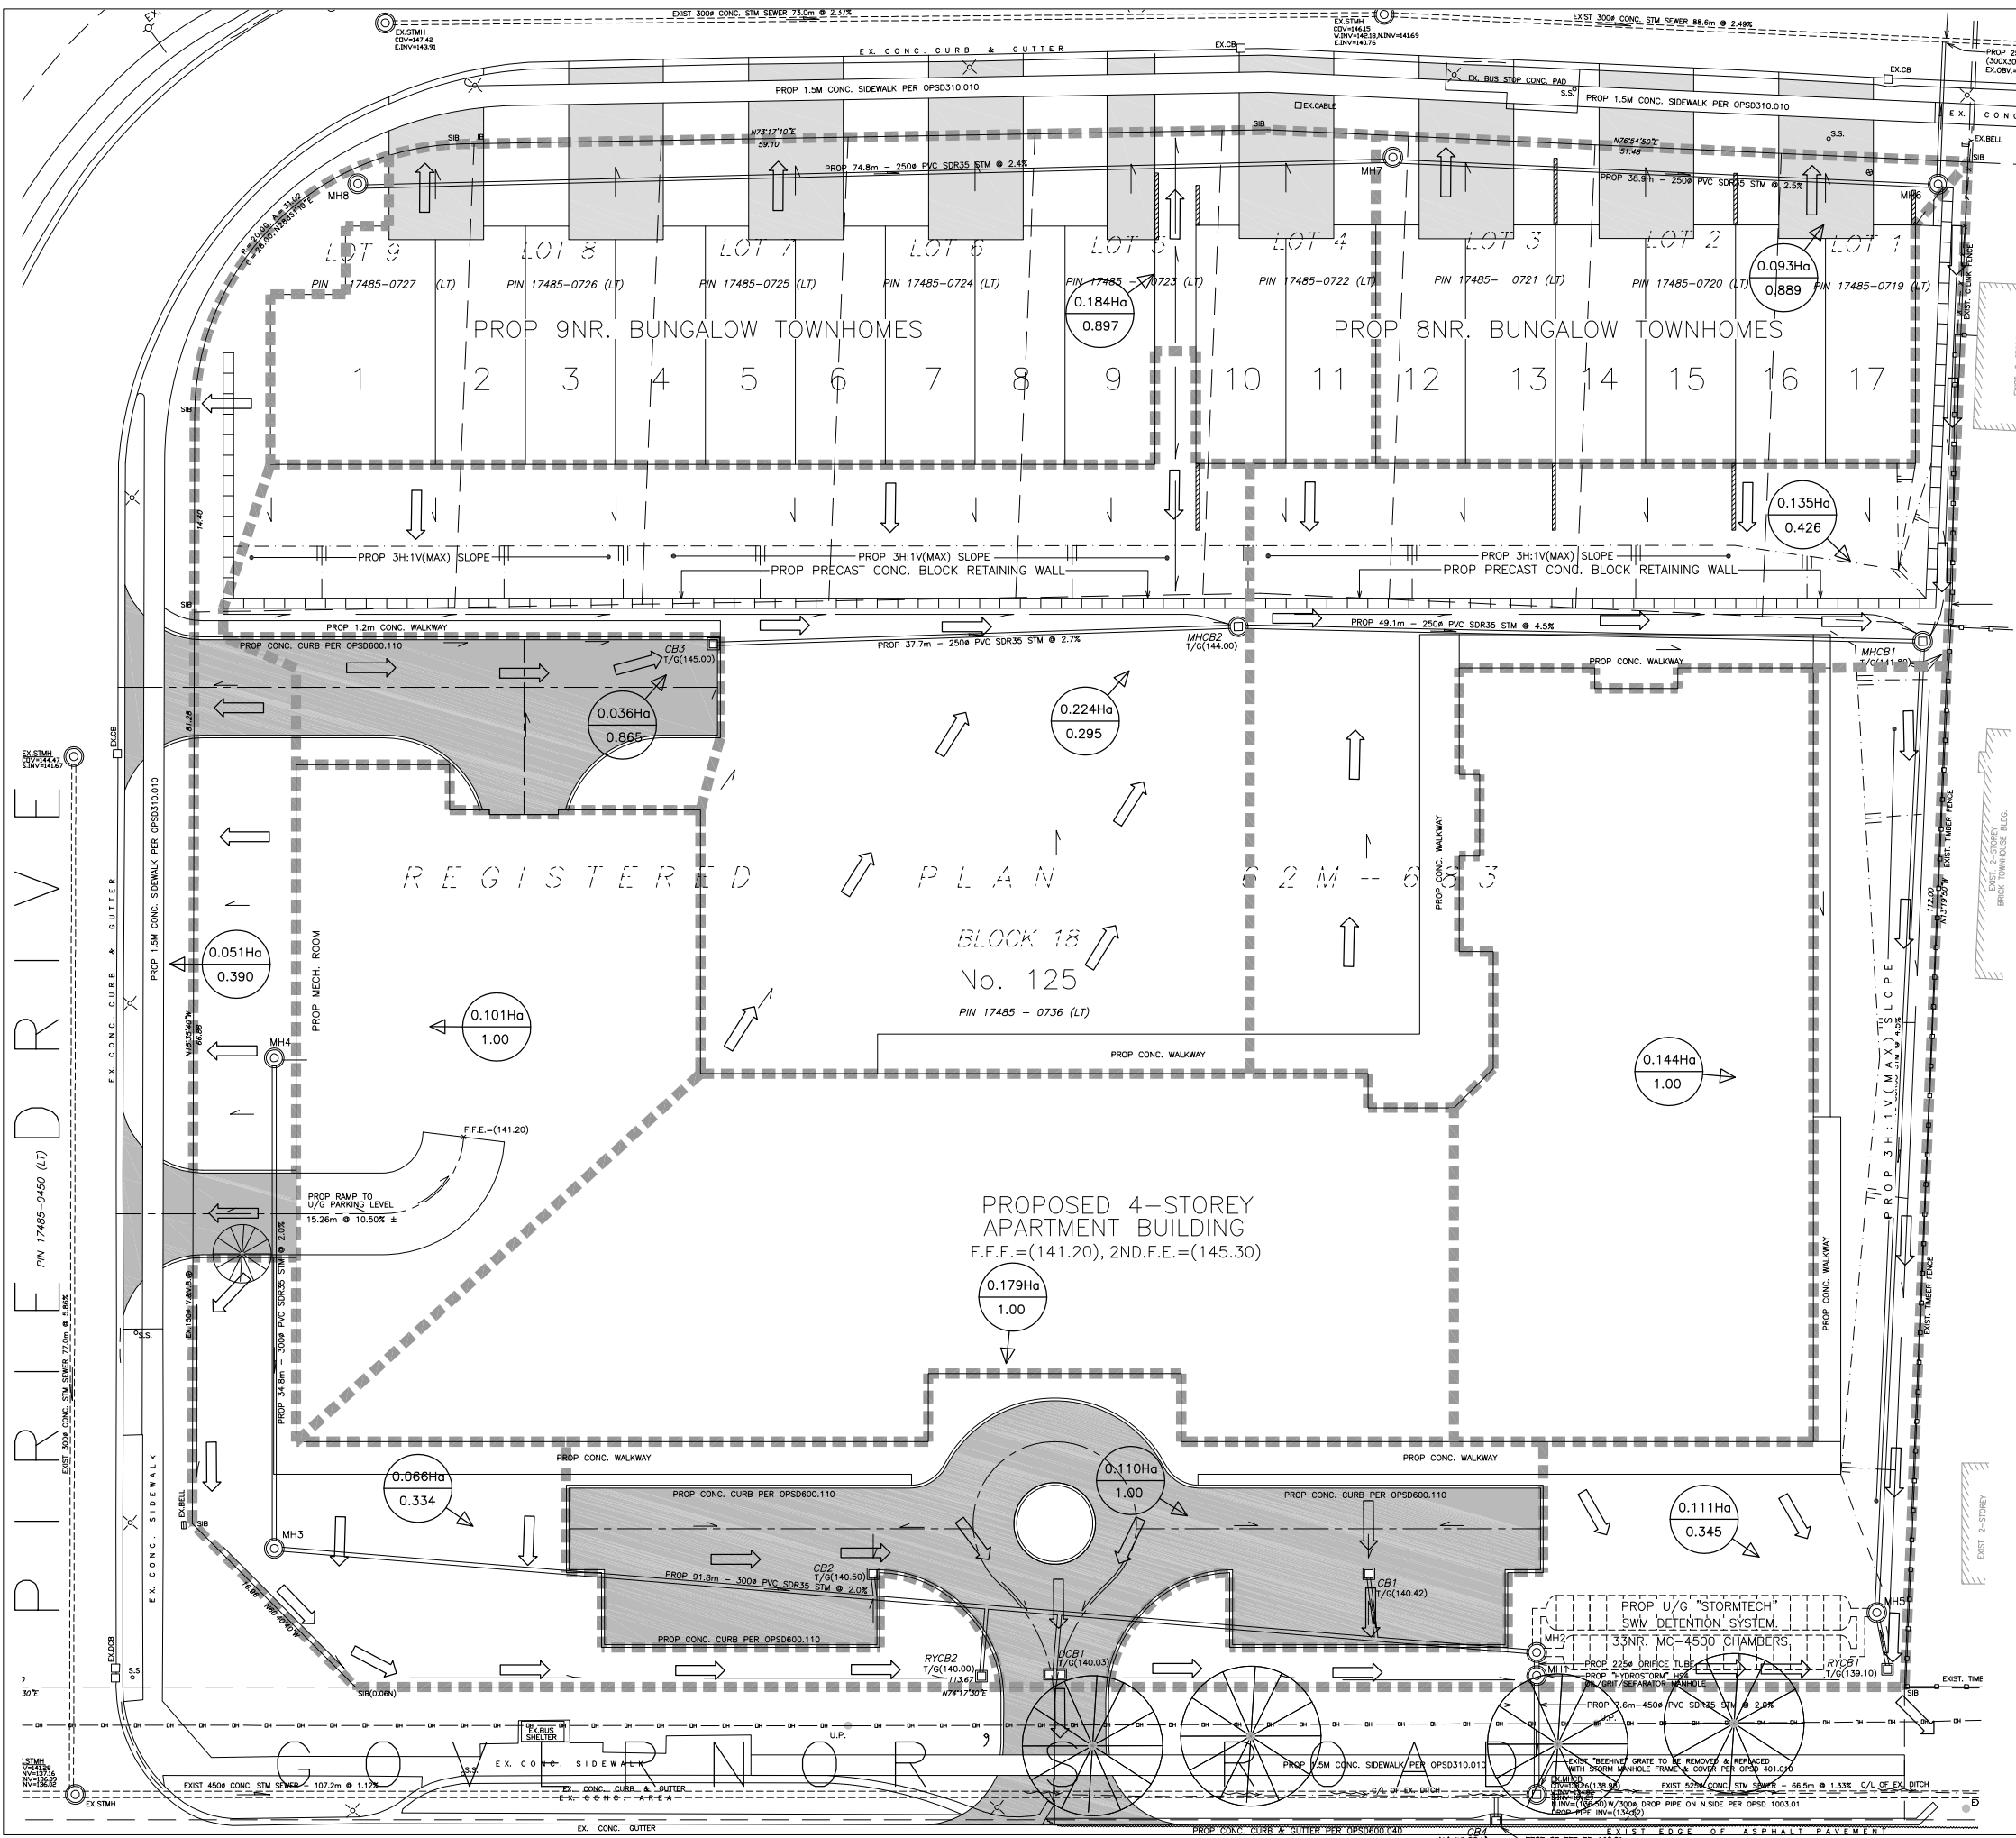

LICENSED PROFESSIONAL ENGINEER  
 D.P. JOYCE  
 OCT. 12, 2020  
 PROVINCE OF ONTARIO

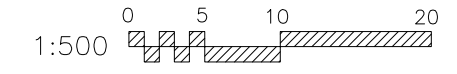

- LEGEND :**
- DENOTES MAJOR STORM OVERLAND ROUTE
  - DENOTES CATCHMENT BOUNDARY
  - DENOTES DRAINAGE DIRECTION
  - DENOTES AREA IN HECTARES (Ha.)
  - DENOTES CO-EFFICIENT OF IMPERVIOUSNESS "C"
  - DENOTES EXTERNAL CONTRIBUTION AREA.

**POST-DEV SITE CHARACTERISTICS**

BUNGLOW UNITS	=	1,973.97SQ. M. (C=1.00)
BUNGLOW DRIVEWAYS	=	424.14SQ. M. (C=1.00)
CONC. RETAINING WALL	=	130.72SQ. M. (C=1.00)
HIGH RISE BUILDING	=	4,238.41SQ. M. (C=1.00)
ASPHALT AREAS	=	1,259.00SQ. M. (C=1.00)
CONC. WALKWAY AREA	=	748.33SQ. M. (C=1.00)
GRASSED AREAS	=	5,573.74SQ. M. (C=0.20)
<b>TOTAL SITE</b>	<b>=</b>	<b>14,348.31SQ. M. (C=0.689)</b>

NO	DATE	BY	REVISION

TITLE  
**POST-DEV STM AREA PLAN**  
 TO ACCOMPANY ZBA APPLICATION ZRA-20-\_\_\_\_  
 (PER FC-20-018)

PROJECT  
**125 PIRIE DRIVE, DUNDAS**  
**PROP. 17NR BUNGALOW TOWNHOMES &**  
**155 UNIT 4-STORY SENIOR'S APARTMENT BLDG.**

© 2020, ALL RIGHTS RESERVED  
 SIDNEY W. WOODS ENGINEERING (2011) INC.

SHEET STM-POST  
 INDEX NO. E-1338

# StormTech MC-4500 Chamber

Designed to meet the most stringent industry performance standards for superior structural integrity while providing designers with a cost-effective method to save valuable land and protect water resources. The StormTech system is designed primarily to be used under parking lots thus maximizing land usage for commercial and municipal applications.



## StormTech MC-4500 Chamber (not to scale)

### Nominal Chamber Specifications

Size (L x W x H)	52" (1321 mm) x 100" (2540 mm) x 60" (1524 mm)
Chamber Storage	106.5 ft <sup>3</sup> (3.01 m <sup>3</sup> )
Min. Installed Storage*	162.6 ft <sup>3</sup> (4.60 m <sup>3</sup> )
Weight	120 lbs (54.4 kg)

\* This assumes a minimum of 12" (300 mm) of stone above, 9" (230 mm) of stone below chambers, 9" (230 mm) of stone between chambers/end caps and 40% stone porosity.

## StormTech MC-4500 End Cap (not to scale)

### Nominal End Cap Specifications

Size (L x W x H)	35.1" (891 mm) x 90.2" (2291 mm) x 59.4" (1509 mm)
End Cap Storage	35.7 ft <sup>3</sup> (1.01 m <sup>3</sup> )
Min. Installed Storage*	108.7 ft <sup>3</sup> (3.08 m <sup>3</sup> )
Weight	120 lbs (54.4 kg)


\*This assumes a minimum of 12" (300 mm) of stone above, 9" (230 mm) of stone below, 12" (300 mm) of stone perimeter, 9" (230 mm) of stone between chambers/end caps and 40% stone porosity.

## Shipping

7 chambers/pallet

7 end caps/pallet

11 pallets/truck

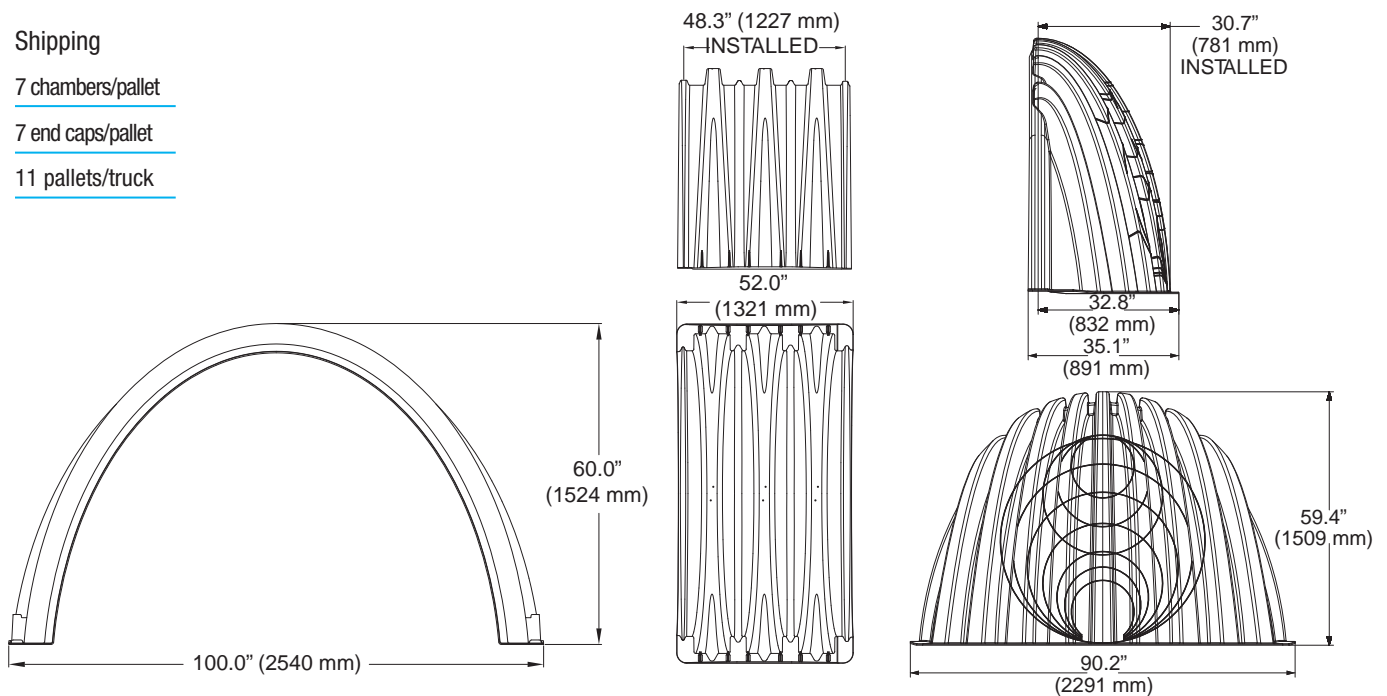

# StormTech MC-4500 Chamber

## Storage Volume Per Chamber/End Cap ft<sup>3</sup> (m<sup>3</sup>)

	Bare Unit Storage ft <sup>3</sup> (m <sup>3</sup> )	Chamber/End Cap and Stone Unit Volume — Stone Foundation Storage Depth in. (mm)			
		9	12	15	18
		(230)	(300)	(375)	(450)
<b>MC-4500 Chamber</b>	106.5 (3.02)	162.6 (4.60)	166.3 (4.71)	169.9 (4.81)	173.6 (4.91)
<b>MC-4500 End Cap</b>	35.7 (1.0)	108.7 (3.08)	111.9 (3.17)	115.2 (3.26)	118.4 (3.35)

NOTE: Assumes 9" (230 mm) row spacing, 40% stone porosity, 12" (300 mm) stone above and includes the bare chamber/end cap volume. End cap volume assumes 12" (300 mm) stone perimeter.

## Volume of Excavation Per Chamber/End Cap in yd<sup>3</sup> (m<sup>3</sup>)

	Stone Foundation Depth			
	9" (230 mm)	12" (300 mm)	15" (375 mm)	18" (450 mm)
<b>MC-3500</b>	10.5 (8.0)	10.8 (8.3)	11.2 (8.5)	11.5 (8.8)
<b>End Cap</b>	9.3 (7.1)	9.6 (7.3)	9.9 (7.6)	10.2 (7.8)

NOTE: Assumes 9" (230 mm) of separation between chamber rows, 12" (300 mm) of perimeter in front of end caps, and 24" (600 mm) of cover. The volume of excavation will vary as the depth of cover increases.




## Amount of Stone Per Chamber

ENGLISH tons (yd <sup>3</sup> )	Stone Foundation Depth			
	9"	12"	15"	18"
<b>MC-4500</b>	7.4 (5.2)	7.8 (5.5)	8.3 (5.9)	8.8 (6.2)
<b>End Cap</b>	9.6 (6.8)	10.0 (7.1)	10.4 (7.4)	10.9 (7.7)
METRIC kg (m <sup>3</sup> )	230 mm	300 mm	375 mm	450 mm
<b>MC-4500</b>	6681 (4.0)	7117 (4.2)	7552 (4.5)	7987 (4.7)
<b>End Cap</b>	8691 (5.2)	9075 (5.4)	9460 (5.6)	9845 (5.9)

NOTE: Assumes 12" (300 mm) of stone above, 9" (230 mm) row spacing, and 12" (300 mm) of perimeter stone in front of end caps.



## General Cross Section

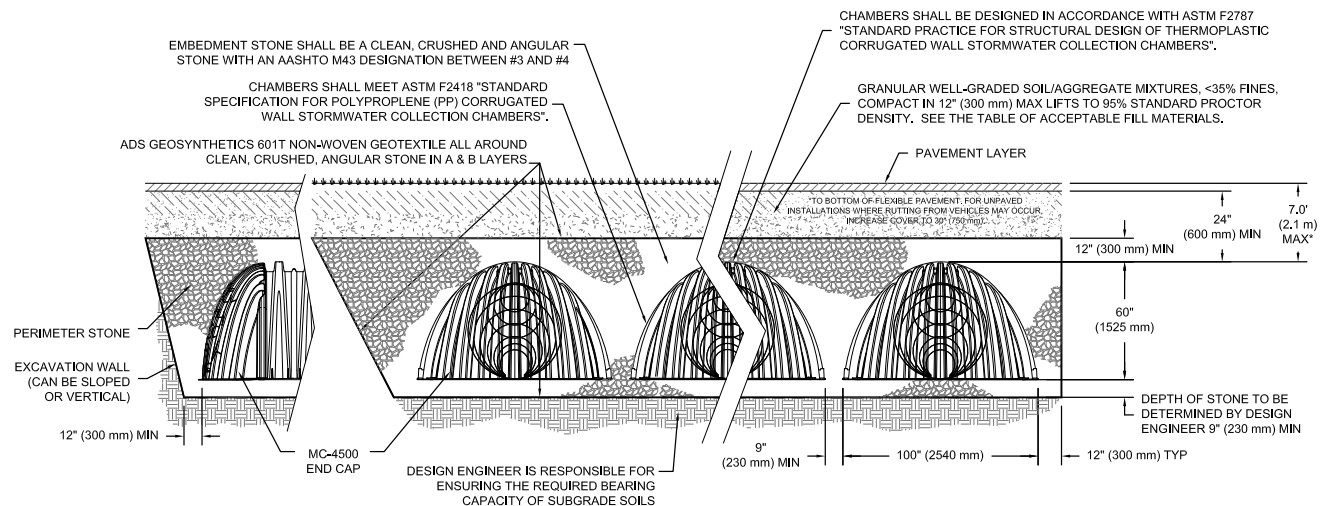

\*FOR COVER DEPTHS GREATER THAN 7.0' (2.1 m) PLEASE CONTACT STORMTECH

THE INSTALLED CHAMBER SYSTEM SHALL PROVIDE THE LOAD FACTORS SPECIFIED IN THE AASHTO LRFD BRIDGE DESIGN SPECIFICATIONS SECTION 12.12 FOR EARTH AND LIVE LOADS, WITH CONSIDERATION FOR IMPACT AND MULTIPLE VEHICLE PRESENCES.



## 5.0 Cumulative Storage Volumes

**Tables 9 and 10** provide cumulative storage volumes for the MC-4500 chamber and end cap. These tables can be used to calculate the stage-storage relationship for the retention or detention system. Digital spreadsheets in which the number of chambers and end caps can be

input for quick cumulative storage calculations are available at [www.stormtech.com](http://www.stormtech.com). For assistance with site-specific calculations or input into routing software, contact the StormTech Technical Services Department.

**TABLE 9 – MC-4500 Incremental Storage Volume Per Chamber**

*Assumes 40% stone porosity. Calculations are based upon a 9" (230 mm) stone base under the chambers, 12" (300 mm) of stone above chambers, and 9" (230 mm) spacing between chambers.*

Depth of Water in System Inches (mm)	Cumulative Chamber Storage ft <sup>3</sup> (m <sup>3</sup> )	Total System Cumulative Storage ft <sup>3</sup> (m <sup>3</sup> )
81 (2057)	0	162.62 (4.605)
80 (2032)	0	161.40 (4.570)
79 (2007)	Stone	160.18 (4.536)
78 (1981)	Cover	158.96 (4.501)
77 (1956)	0	157.74 (4.467)
76 (1930)	0	156.52 (4.432)
75 (1905)	0	155.30 (4.398)
74 (1880)	0	154.09 (4.363)
73 (1854)	0	152.87 (4.329)
72 (1829)	0	151.65 (4.294)
71 (1803)	0	150.43 (4.260)
70 (1778)	0	149.21 (4.225)
69 (1753)	106.51 (3.016)	147.99 (4.191)
68 (1727)	106.47 (3.015)	146.75 (4.156)
67 (1702)	106.35 (3.012)	145.46 (4.119)
66 (1676)	106.18 (3.007)	144.14 (4.082)
65 (1651)	105.98 (3.001)	142.80 (4.044)
64 (1626)	105.71 (2.993)	141.42 (4.005)
63 (1600)	105.25 (2.981)	139.93 (3.962)
62 (1575)	104.59 (2.962)	138.31 (3.917)
61 (1549)	103.79 (2.939)	136.61 (3.869)
60 (1524)	102.88 (2.913)	134.85 (3.819)
59 (1499)	101.88 (2.885)	133.03 (3.767)
58 (1473)	100.79 (2.854)	131.16 (3.714)
57 (1448)	99.63 (2.821)	129.24 (3.660)
56 (1422)	98.39 (2.786)	127.28 (3.604)
55 (1397)	97.10 (2.749)	125.28 (3.548)
54 (1372)	95.73 (2.711)	123.25 (3.490)
53 (1346)	94.32 (2.671)	121.18 (3.431)
52 (1321)	92.84 (2.629)	119.08 (3.372)
51 (1295)	91.32 (2.586)	116.94 (3.311)
50 (1270)	89.74 (2.541)	114.78 (3.250)
49 (1245)	88.12 (2.495)	112.59 (3.188)
48 (1219)	86.45 (2.448)	110.37 (3.125)
47 (1194)	84.75 (2.400)	108.13 (3.062)
46 (1168)	83.00 (2.350)	105.86 (2.998)
45 (1143)	81.21 (2.300)	103.56 (2.933)
44 (1118)	79.38 (2.248)	101.25 (2.867)
43 (1092)	77.52 (2.195)	98.91 (2.801)

**NOTE:** Add 1.22 ft<sup>3</sup> (0.035 m<sup>3</sup>) of storage for each additional inch (25 mm) of stone foundation. Contact StormTech for cumulative volume spreadsheets in digital format.

Depth of Water in System Inches (mm)	Cumulative Chamber Storage ft <sup>3</sup> (m <sup>3</sup> )	Total System Cumulative Storage ft <sup>3</sup> (m <sup>3</sup> )
42 (1067)	75.62 (2.141)	96.55 (2.734)
41 (1041)	73.69 (2.087)	94.18 (2.667)
40 (1016)	71.72 (2.031)	91.78 (2.599)
39 (991)	69.73 (1.974)	89.36 (2.531)
38 (965)	67.70 (1.917)	86.93 (2.462)
37 (948)	65.65 (1.859)	84.48 (2.392)
36 (914)	63.57 (1.800)	82.01 (2.322)
35 (889)	61.46 (1.740)	79.53 (2.252)
34 (864)	59.32 (1.680)	77.03 (2.181)
33 (838)	57.17 (1.619)	74.52 (2.110)
32 (813)	54.98 (1.557)	71.99 (2.038)
31 (787)	52.78 (1.495)	69.45 (1.966)
30 (762)	50.55 (1.431)	66.89 (1.894)
29 (737)	48.30 (1.368)	64.32 (1.821)
28 (711)	46.03 (1.303)	61.74 (1.748)
27 (686)	43.74 (1.239)	59.15 (1.675)
26 (680)	41.43 (1.173)	56.55 (1.601)
25 (610)	39.11 (1.107)	53.93 (1.527)
24 (609)	36.77 (1.041)	51.31 (1.453)
23 (584)	34.41 (0.974)	48.67 (1.378)
22 (559)	32.03 (0.907)	46.03 (1.303)
21 (533)	29.64 (0.839)	43.38 (1.228)
20 (508)	27.23 (0.771)	40.71 (1.153)
19 (483)	24.81 (0.703)	38.04 (1.077)
18 (457)	22.38 (0.634)	35.37 (1.001)
17 (432)	19.94 (0.565)	32.68 (0.925)
16 (406)	17.48 (0.495)	29.99 (0.849)
15 (381)	15.01 (0.425)	27.29 (0.773)
14 (356)	12.53 (0.355)	24.58 (0.696)
13 (330)	10.05 (0.284)	21.87 (0.619)
12 (305)	7.55 (0.214)	19.15 (0.542)
11 (279)	5.04 (0.143)	16.43 (0.465)
10 (254)	2.53 (0.072)	13.70 (0.388)
9 (229)	0	10.97 (0.311)
8 (203)	0	9.75 (0.276)
7 (178)	0	8.53 (0.242)
6 (152)	Stone	7.31 (0.207)
5 (127)	Foundation	6.09 (0.173)
4 (102)	0	4.87 (0.138)
3 (76)	0	3.66 (0.104)
2 (51)	0	2.44 (0.069)
1 (25)	0	1.22 (0.035)



## 5.0 Cumulative Storage Volumes

**TABLE 10 – MC-4500 Incremental Storage Volume Per End Cap**

Assumes 40% stone porosity. Calculations are based upon a 9" (229 mm) stone base under the end caps, 12" (300 mm) of stone above end caps, 9" (230 mm) of spacing between end caps and 12" (300 mm) of stone perimeter.

Depth of Water in System Inches (mm)	Cumulative Chamber Storage ft <sup>3</sup> (m <sup>3</sup> )	Total System Cumulative Storage ft <sup>3</sup> (m <sup>3</sup> )
81 (2057)	0	108.69 (3.078)
80 (2032)	0	107.62 (3.047)
79 (2007)	Stone	106.54 (3.017)
78 (1981)	Cover	105.46 (2.986)
77 (1956)	0	104.38 (2.956)
76 (1930)	0	103.31 (2.925)
75 (1905)	0	102.23 (2.895)
74 (1880)	0	101.15 (2.864)
73 (1854)	0	100.07 (2.834)
72 (1829)	0	99.00 (2.803)
71 (1803)	0	97.92 (2.773)
70 (1778)	0	96.84 (2.742)
69 (1753)	35.71 (1.011)	95.76 (2.712)
68 (1727)	35.71 (1.011)	94.69 (2.681)
67 (1702)	35.70 (1.011)	93.60 (2.651)
66 (1676)	35.67 (1.010)	92.51 (2.620)
65 (1651)	35.62 (1.009)	91.40 (2.588)
64 (1626)	35.56 (1.007)	90.29 (2.557)
63 (1600)	35.47 (1.004)	89.16 (2.525)
62 (1575)	35.36 (1.001)	88.01 (2.492)
61 (1549)	35.21 (0.997)	86.85 (2.459)
60 (1524)	35.05 (0.992)	85.67 (2.426)
59 (1499)	34.86 (0.987)	84.48 (2.392)
58 (1473)	34.64 (0.981)	83.27 (2.358)
57 (1448)	34.40 (0.974)	82.05 (2.323)
56 (1422)	34.13 (0.966)	80.81 (2.288)
55 (1397)	33.83 (0.958)	79.55 (2.253)
54 (1372)	33.51 (0.949)	78.28 (2.217)
53 (1346)	33.16 (0.939)	77.00 (2.180)
52 (1321)	32.79 (0.928)	75.70 (2.144)
51 (1295)	32.39 (0.917)	74.38 (2.106)
50 (1270)	31.98 (0.906)	73.06 (2.069)
49 (1245)	31.54 (0.893)	71.71 (2.031)
48 (1219)	31.07 (0.880)	70.36 (1.992)
47 (1194)	30.59 (0.866)	68.99 (1.954)
46 (1168)	30.09 (0.852)	67.61 (1.915)
45 (1143)	29.56 (0.837)	66.22 (1.875)
44 (1118)	29.02 (0.822)	64.81 (1.835)
43 (1092)	28.45 (0.806)	63.40 (1.795)

**NOTE:** Add 1.08 ft<sup>3</sup> (0.031 m<sup>3</sup>) of storage for each additional inch (25 mm) of stone foundation. Contact stormtech for cumulative volume spreadsheets in digital format.

Depth of Water in System Inches (mm)	Cumulative Chamber Storage ft <sup>3</sup> (m <sup>3</sup> )	Total System Cumulative Storage ft <sup>3</sup> (m <sup>3</sup> )
42 (1067)	27.87 (0.789)	61.97 (1.755)
41 (1041)	27.27 (0.772)	60.53 (1.714)
40 (1016)	26.65 (0.755)	59.08 (1.673)
39 (991)	26.01 (0.736)	57.62 (1.632)
38 (965)	25.35 (0.718)	56.15 (1.590)
37 (948)	24.68 (0.699)	54.67 (1.548)
36 (914)	23.99 (0.679)	53.18 (1.506)
35 (889)	23.28 (0.659)	51.68 (1.463)
34 (864)	22.56 (0.639)	50.17 (1.421)
33 (838)	21.82 (0.618)	48.64 (1.377)
32 (813)	21.06 (0.596)	47.11 (1.334)
31 (787)	20.29 (0.575)	45.57 (1.290)
30 (762)	19.50 (0.552)	44.02 (1.247)
29 (737)	18.70 (0.530)	42.46 (1.202)
28 (711)	17.88 (0.506)	40.89 (1.158)
27 (686)	17.04 (0.483)	39.31 (1.113)
26 (680)	16.19 (0.459)	37.73 (1.068)
25 (610)	15.33 (0.434)	36.14 (1.023)
24 (609)	14.46 (0.410)	34.53 (0.978)
23 (584)	13.58 (0.384)	32.93 (0.932)
22 (559)	12.68 (0.359)	31.31 (0.887)
21 (533)	11.77 (0.333)	29.69 (0.841)
20 (508)	10.85 (0.307)	28.06 (0.794)
19 (483)	9.91 (0.281)	26.42 (0.748)
18 (457)	8.97 (0.254)	24.77 (0.702)
17 (432)	8.01 (0.227)	23.12 (0.655)
16 (406)	7.04 (0.199)	21.46 (0.608)
15 (381)	6.07 (0.172)	19.80 (0.561)
14 (356)	5.08 (0.144)	18.13 (0.513)
13 (330)	4.08 (0.116)	16.45 (0.466)
12 (305)	3.07 (0.087)	14.77 (0.418)
11 (279)	2.06 (0.058)	13.09 (0.371)
10 (254)	1.03 (0.029)	11.39 (0.323)
9 (229)	0	9.70 (0.275)
8 (203)	0	8.62 (0.244)
7 (178)	0	7.54 (0.214)
6 (152)	Stone	6.46 (0.183)
5 (127)	Foundation	5.39 (0.153)
4 (102)	0	4.31 (0.122)
3 (76)	0	3.23 (0.092)
2 (51)	0	2.15 (0.061)
1 (25)	0	1.08 (0.031)



MIDUSS OUTPUT – 125 Pirie Drive, Dundas, Post Development 5-Year Storm

```

Output File (4.7) 125PIRIE      opened 2020-10-14  22:52
Units used are defined by G =    9.810
   72  144    5.000      are MAXDT MAXHYD & DTMIN values
Licensee: Sidney W Woods Engineering Inc.
2  STORM
   1      1=Chicago;2=Huff;3=User;4=Cdn1hr;5=Historic
688.200  Coefficient a
   5.000  Constant b (min)
   .753   Exponent c
   .450   Fraction to peak r
360.000  Duration ó 360 min
          48.580 mm    Total depth
3  IMPERVIOUS
   1      Option 1=SCS CN/C; 2=Horton; 3=Green-Ampt; 4=Repeat
   .020   Manning "n"
100.000  SCS Curve No or C
   .100   Ia/S Coefficient
   .000   Initial Abstraction
4  CATCHMENT
   1.000  ID No.ó 99999
   1.107  Area in hectares
   75.000 Length (PERV) metres
   2.000  Gradient (%)
   65.100 Per cent Impervious
   75.000 Length (IMPERV)
   .000   %Imp. with Zero Dpth
   1      Option 1=SCS CN/C; 2=Horton; 3=Green-Ampt; 4=Repeat
   .200   Manning "n"
   65.000 SCS Curve No or C
   .100   Ia/S Coefficient
   13.677 Initial Abstraction
   1      Option 1=Trianglr; 2=Rectanglr; 3=SWM HYD; 4=Lin. Reserv
          .177      .000      .000      .000 c.m/s
          .146      .991      .696      C perv/imperv/total
15  ADD RUNOFF
          .177      .177      .000      .000 c.m/s
10  POND
15  Depth - Discharge - Volume sets
   .000      .000      .0
   .125      .0510     8.1
   .250      .0722     21.0
   .375      .0884     32.4
   .500      .102      44.0
   .625      .114      55.0
   .750      .125      65.3
   .875      .135      74.7
   1.000     .144      83.2
   1.125     .153      90.8
   1.250     .162      97.2
   1.375     .169     101.9
   1.500     .177     103.0
   1.625     .184     104.2
   1.750     .191     104.6
Peak Outflow = .110 c.m/s
Maximum Depth = .582 metres
Maximum Storage = 51. c.m
          .177      .177      .110      .000 c.m/s
16  NEXT LINK
          .177      .110      .110      .000 c.m/s

```

MIDUSS OUTPUT – 125 Pirie Drive, Dundas, Post Development 5-Year Storm

```

8     PIPE
      .500      Minimum velocity  m/sec
      4.000      Maximum velocity  m/sec
      .013      Pipe Manning's 'n'
      .300      Diameter in metres
      2.000      Select Grade in %
      Depth      =      .204 metres
      Velocity    =      2.151 m/sec
      Pipe Capacity =      .137 c.m/s
      Critical depth=      .255 metres
9     ROUTE
      7.600      Conduit Length
      .001      Supply X-factor <.5
      2.650      Supply K-lag (sec)
      .500      Beta weighting factor
      5.263      Routing timestep
      1         No. of sub-reaches
      .177      .110      .110      .000 c.m/s
20    MANUAL

```

MIDUSS OUTPUT – 125 Pirie Drive, Dundas, Post Development 100-Year Storm

Output File (4.7) 125PIRIE opened 2020-10-14 23:05  
 Units used are defined by G = 9.810  
 72 144 5.000 are MAXDT MAXHYD & DTMIN values  
 Licensee: Sidney W Woods Engineering Inc.

```

2  STORM
    1      1=Chicago;2=Huff;3=User;4=Cdn1hr;5=Historic
1036.100 Coefficient a
    4.500 Constant b (min)
    .733 Exponent c
    .450 Fraction to peak r
    360.000 Duration ó 360 min
           82.381 mm Total depth

3  IMPERVIOUS
    1      Option 1=SCS CN/C; 2=Horton; 3=Green-Ampt; 4=Repeat
    .020 Manning "n"
100.000 SCS Curve No or C
    .100 Ia/S Coefficient
    .000 Initial Abstraction

4  CATCHMENT
    1.000 ID No.ó 99999
    1.107 Area in hectares
    75.000 Length (PERV) metres
    2.000 Gradient (%)
    65.100 Per cent Impervious
    75.000 Length (IMPERV)
    .000 %Imp. with Zero Dpth
    1      Option 1=SCS CN/C; 2=Horton; 3=Green-Ampt; 4=Repeat
    .200 Manning "n"
    65.000 SCS Curve No or C
    .100 Ia/S Coefficient
    13.677 Initial Abstraction
    1      Option 1=Trianglr; 2=Rectanglr; 3=SWM HYD; 4=Lin. Reserv
           .283 .000 .000 .000 c.m/s
           .279 .984 .738 C perv/imperv/total

15 ADD RUNOFF
    .283 .283 .000 .000 c.m/s




10 POND
15 Depth - Discharge - Volume sets
    .000 .000 .0
    .125 .0510 8.1
    .250 .0722 10.9
    .375 .0884 32.4
    .500 .102 44.0
    .625 .114 55.0
    .750 .125 65.3
    .875 .135 74.7
    1.000 .144 83.2
    1.125 .153 90.8
    1.250 .162 97.2
    1.375 .169 101.9
    1.500 .177 103.0
    1.625 .184 104.2
    1.750 .191 104.6
    Peak Outflow = .167 c.m/s
    Maximum Depth = 1.336 metres
    Maximum Storage = 100. c.m
           .283 .283 .167 .000 c.m/s

16 NEXT LINK
    .283 .167 .167 .000 c.m/s
    
```

MIDUSS OUTPUT – 125 Pirie Drive, Dundas, Post Development 100-Year Storm

```

8      PIPE
      .500      Minimum velocity m/sec
      4.000      Maximum velocity m/sec
      .013      Pipe Manning's 'n'
      .375      Diameter in metres
      2.000      Select Grade in %
      Depth      =      .225 metres
      Velocity    =      2.409 m/sec
      Pipe Capacity =      .248 c.m/s
      Critical depth=      .300 metres
9      ROUTE
      7.600      Conduit Length
      .015      Supply X-factor <.5
      2.367      Supply K-lag (sec)
      .500      Beta weighting factor
      4.615      Routing timestep
      1      No. of sub-reaches
      .283      .167      .167      .000 c.m/s
20     MANUAL
    
```

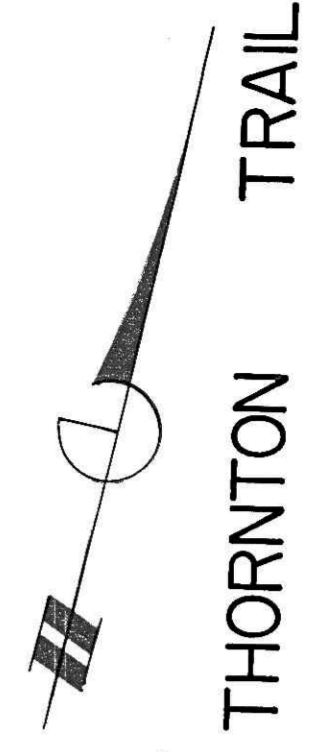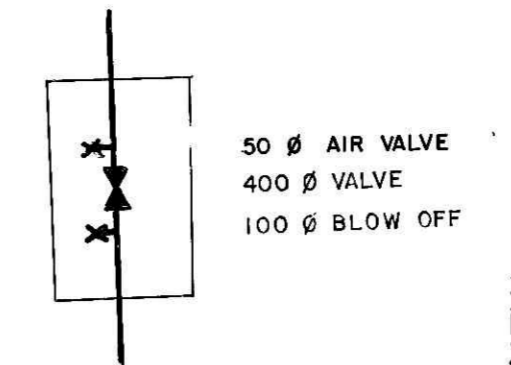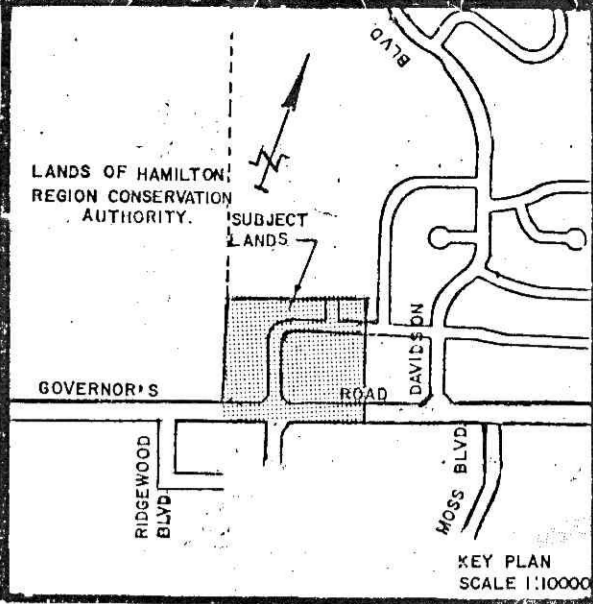


GOVERNOR'S  
(HIGHWAY 99)

PIRIE ROAD

NEWCOMBE ROAD

THORNTON TRAIL

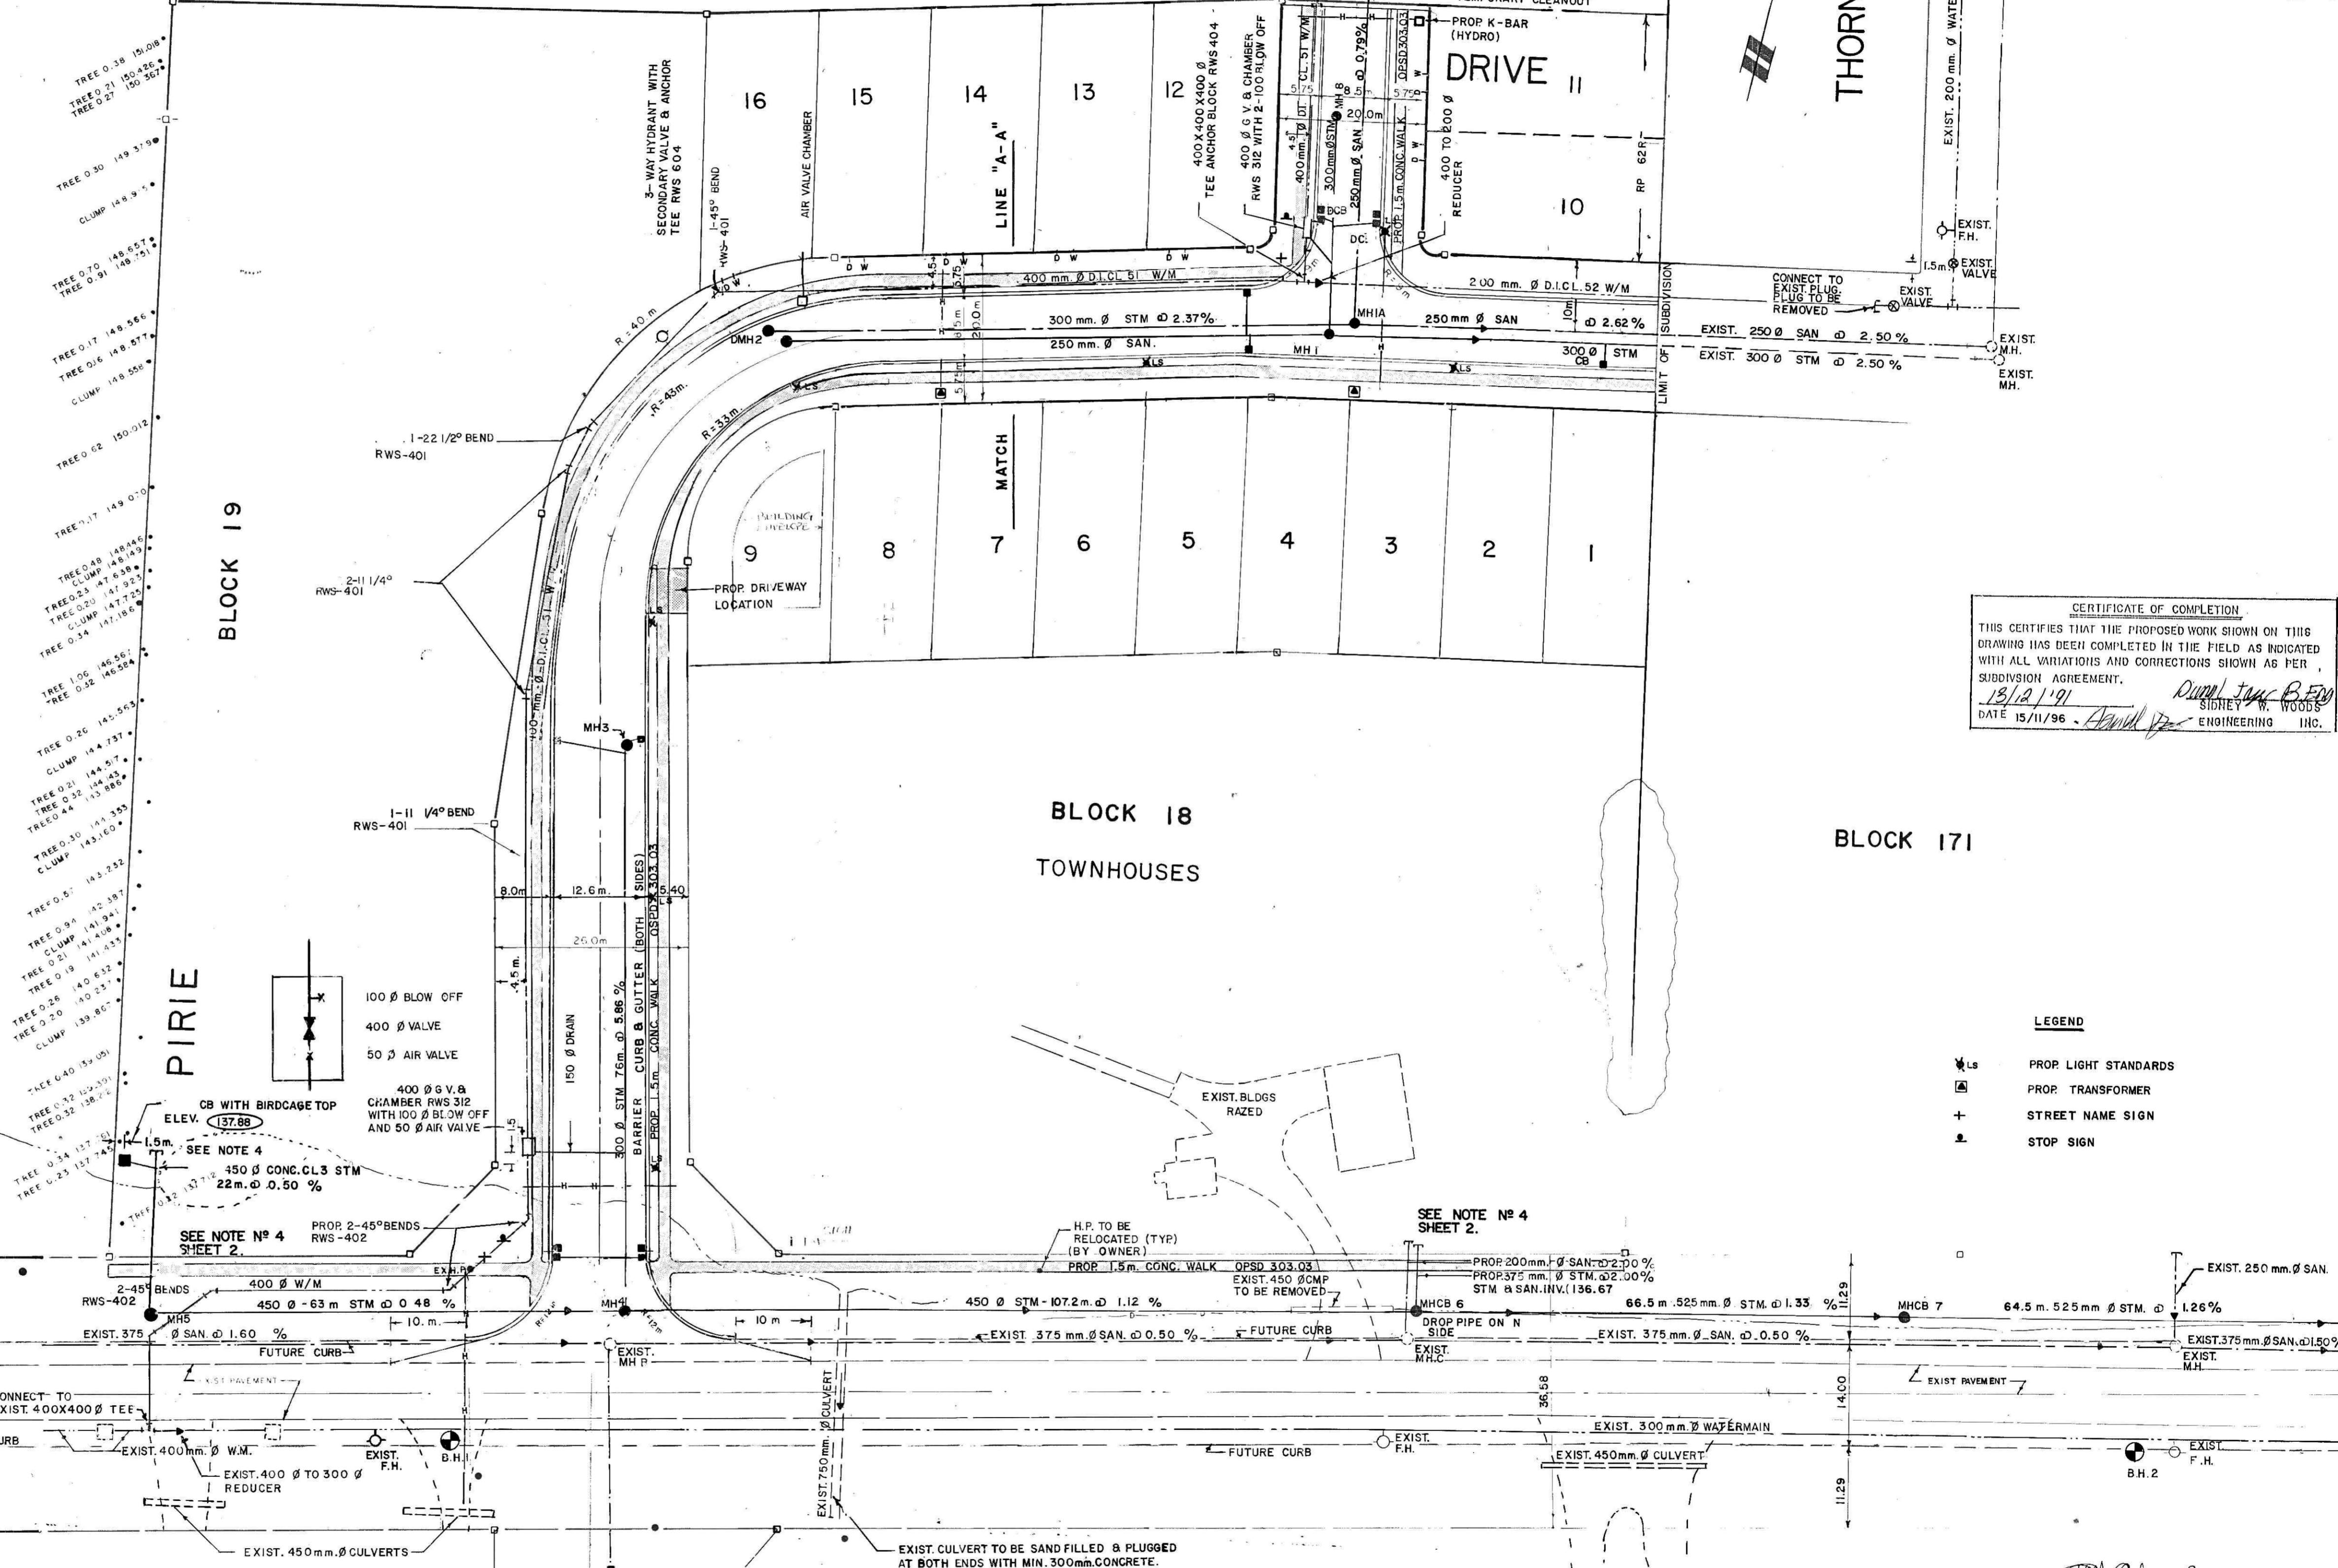

**CERTIFICATE OF COMPLETION**  
THIS CERTIFIES THAT THE PROPOSED WORK SHOWN ON THIS DRAWING HAS BEEN COMPLETED IN THE FIELD AS INDICATED WITH ALL VARIATIONS AND CORRECTIONS SHOWN AS PER SUBDIVISION AGREEMENT.  
13/12/91  
DATE 15/11/96  
SIDNEY W. WOODS  
ENGINEERING INC.

**LEGEND**  
 ◊ LS PROP. LIGHT STANDARDS  
 ◻ PROP. TRANSFORMER  
 + STREET NAME SIGN  
 ■ STOP SIGN

SEE NOTE # 4 SHEET 2.  
 450 Ø CONC. CL 3 STM  
 22m. Ø 0.50 %  
 CB WITH BIRDCAGE TOP  
 ELEV. 137.88  
 SEE NOTE 4

SEE NOTE # 4 SHEET 2.  
 PROP. 200mm. Ø SAN. Ø 2.00 %  
 PROP. 375mm. Ø STM. Ø 2.00 %  
 STM & SAN. INV. (136.67)

Nº	BY	DATE	REVISIONS
6	M.M.	DEC. 91	"AS CONSTRUCTED" INFORMATION
5	H.O.	JUNE 91	STM & SAN. ON CONSERVATION DR. ADDED
4	J.M.	JAN. 91	REMOVE INLET
3	H.O.	DEC. 90	NOTE ON 750 Ø CMP
2	H.O.	SEPT. 90	HYDRO INFO. PER TOWN'S COMMENTS
1	H.O.	JUNE 90	AS PER TOWN'S & REGION'S COMMENTS

CONSULTANT:  
**SIDNEY W. WOODS**  
ENGINEERING INC. HAMILTON, ONTARIO


MUNICIPALITY:  
**TOWN OF DUNDAS**

OWNER:  
**ROBINSON HOMES LTD.**

DATE: Jan 3/91

TITLE: "AS CONSTRUCTED" CONSERVATION RUN (PHASE - ONE) GENERAL PLAN OF SERVICES

DESIGNER: J.M.  
DRAWN: H.O. CHK'D: J.M.  
SCALE: 1:500  
E-1051  
SHEET 5

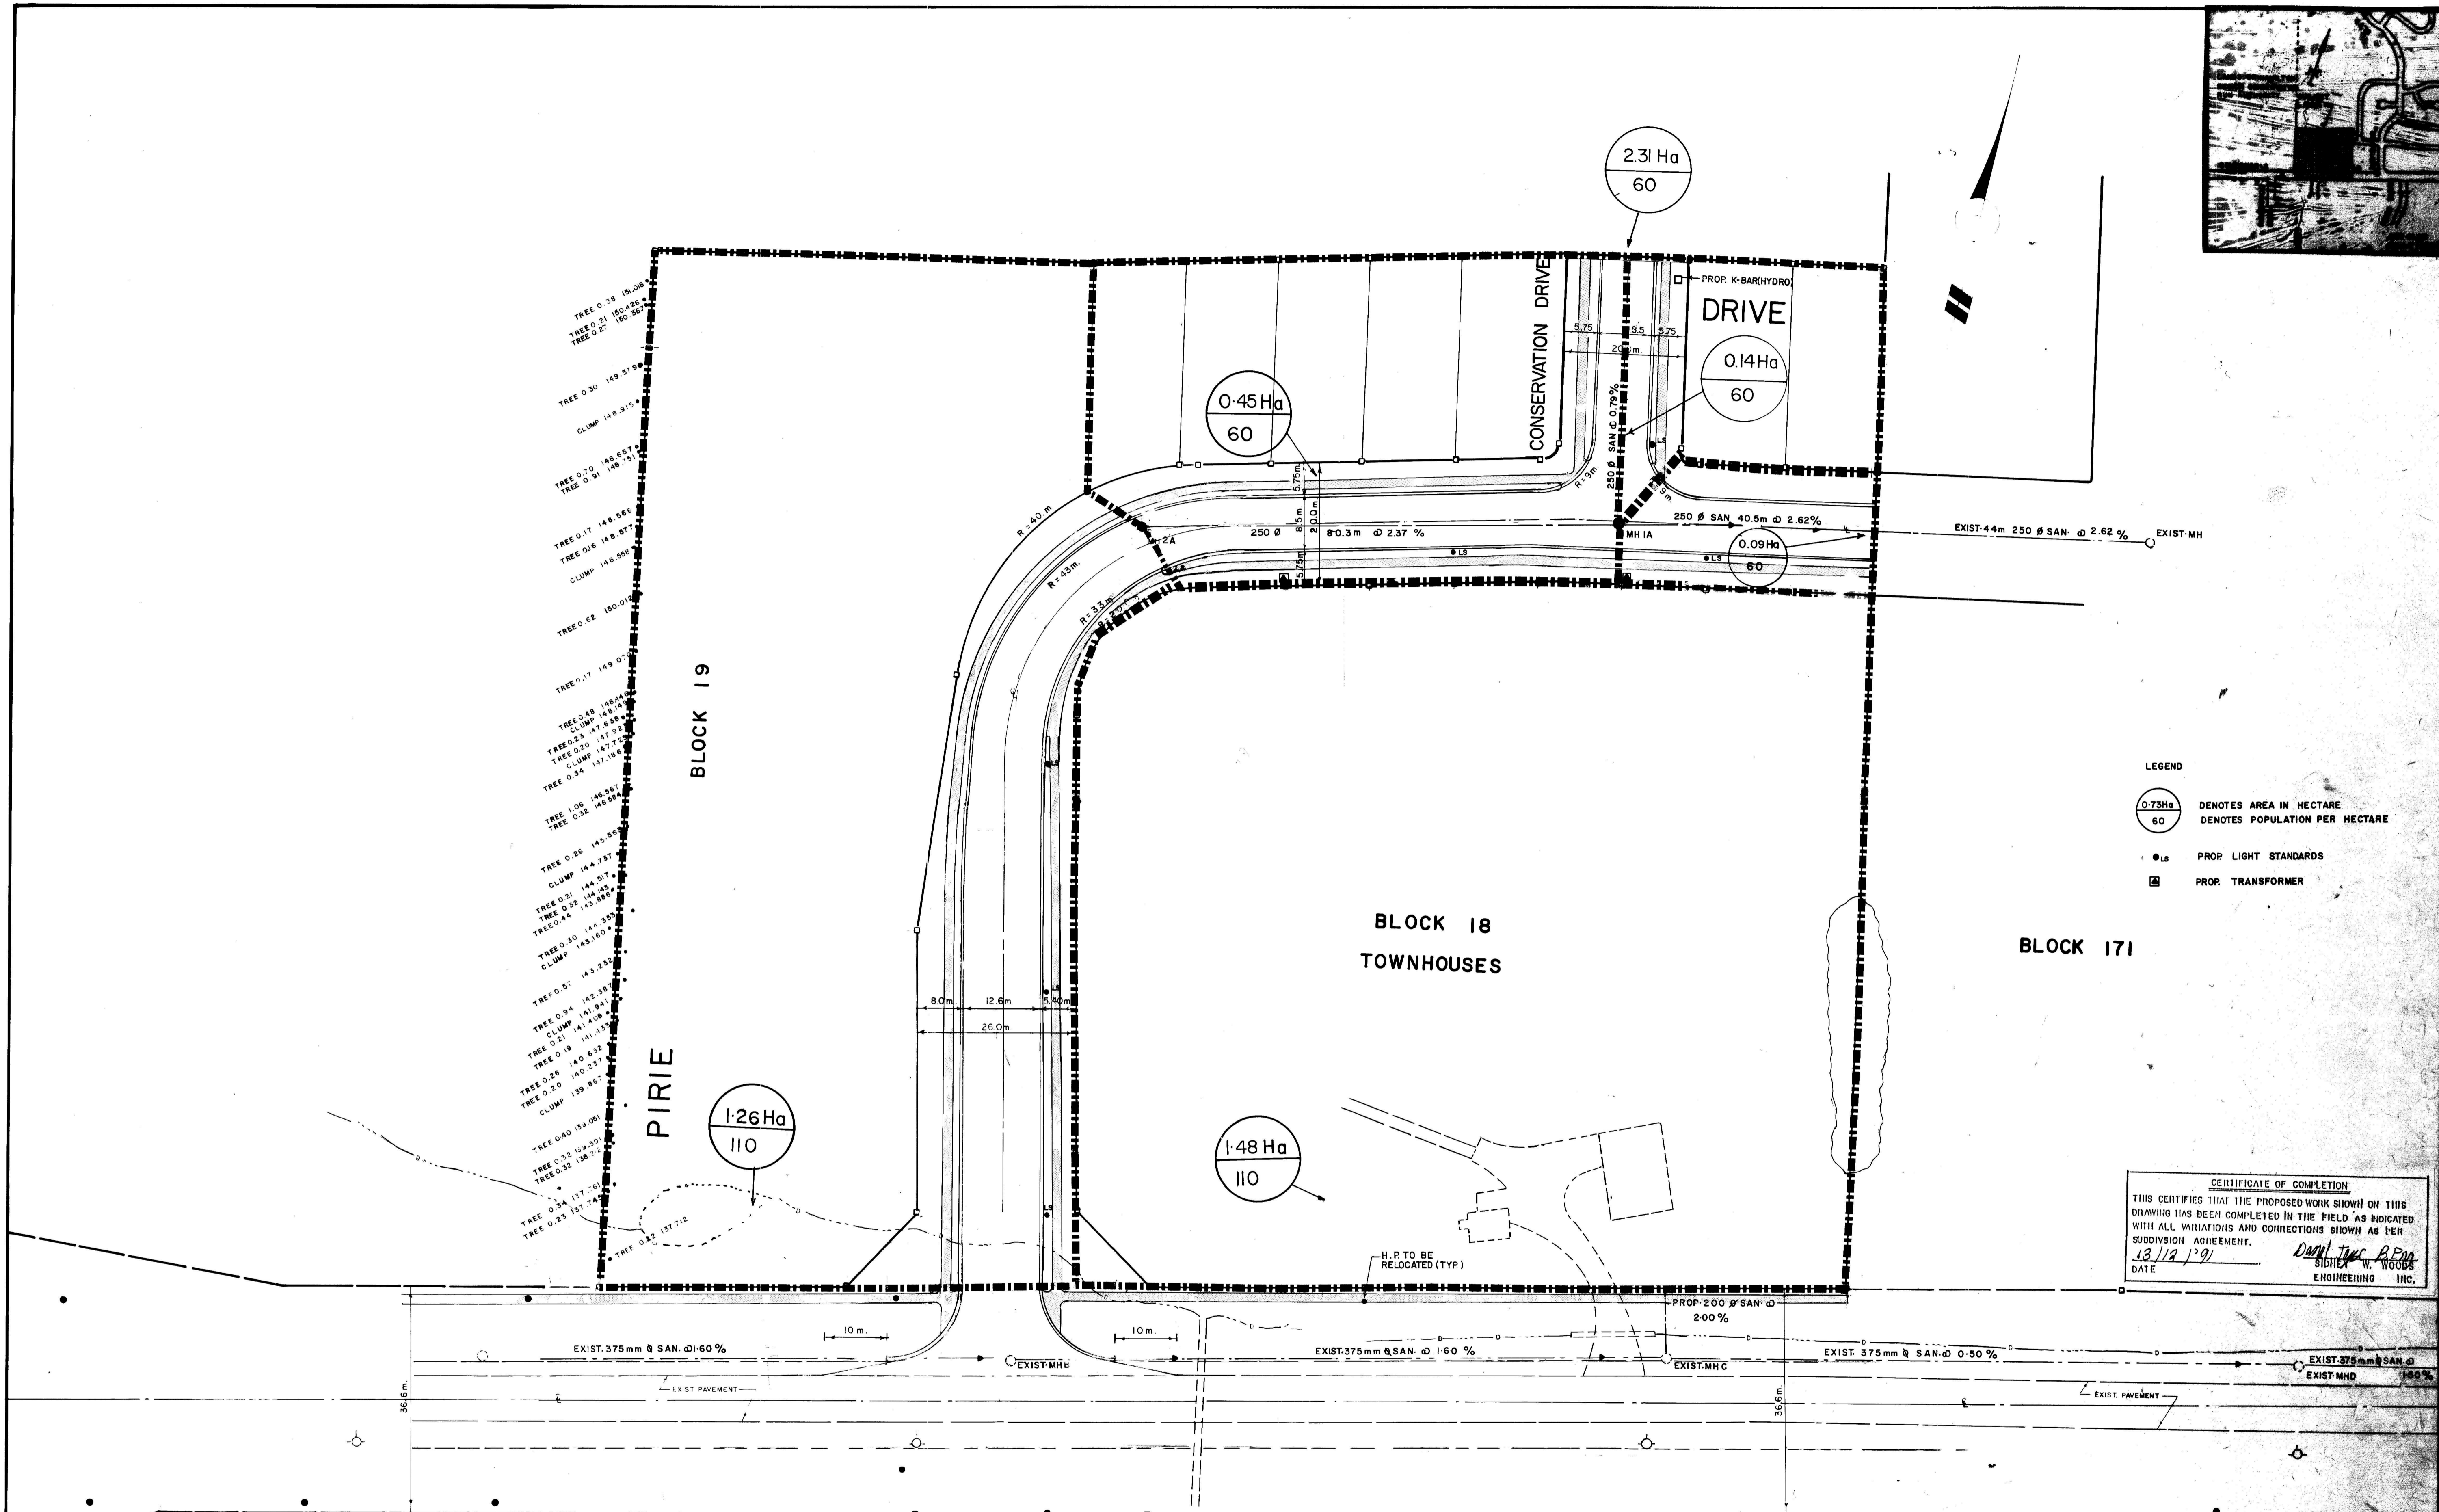

**LEGEND**

○ 0.73Ha  
60 DENOTES AREA IN HECTARE  
60 DENOTES POPULATION PER HECTARE

● LI PROP. LIGHT STANDARDS

□ PROP. TRANSFORMER

**CERTIFICATE OF COMPLETION**

THIS CERTIFIES THAT THE PROPOSED WORK SHOWN ON THIS DRAWING HAS BEEN COMPLETED IN THE FIELD AS INDICATED WITH ALL VARIATIONS AND CORRECTIONS SHOWN AS PER SUBDIVISION AGREEMENT.

DATE: 12/19/91  
SIGNATURE: [Signature]  
SIDNEY W. WOODS ENGINEERING INC.

GOVERNOR'S ROAD  
(HIGHWAY 99)

No	BY	DATE	REVISIONS
2	H. O.	SEPT 90	HYDRO INFO. ADDED PER TOWN'S COMMENTS
1	H. O.	JUNE 90	AS PER TOWN'S & REGION'S COMMENTS

CONSULTANT  
**SIDNEY W. WOODS**  
ENGINEERING INC. HAMILTON, ONTARIO

MUNICIPALITY  
**TOWN OF DUNDAS**

OWNER  
**ROBINSON HOMES LTD.**

TITLE  
**"AS CONSTRUCTED"  
CONSERVATION RUN  
(PHASE - ONE)  
SANITARY AREA PLAN**



Design: [ ] Chk'd: [ ] DATE: JANUARY, 1990

Drawn: H.O. Chk'd: J.M.

SCALE: 1:500

E-1051  
SHEET SAN. OF

*J. Murphy*

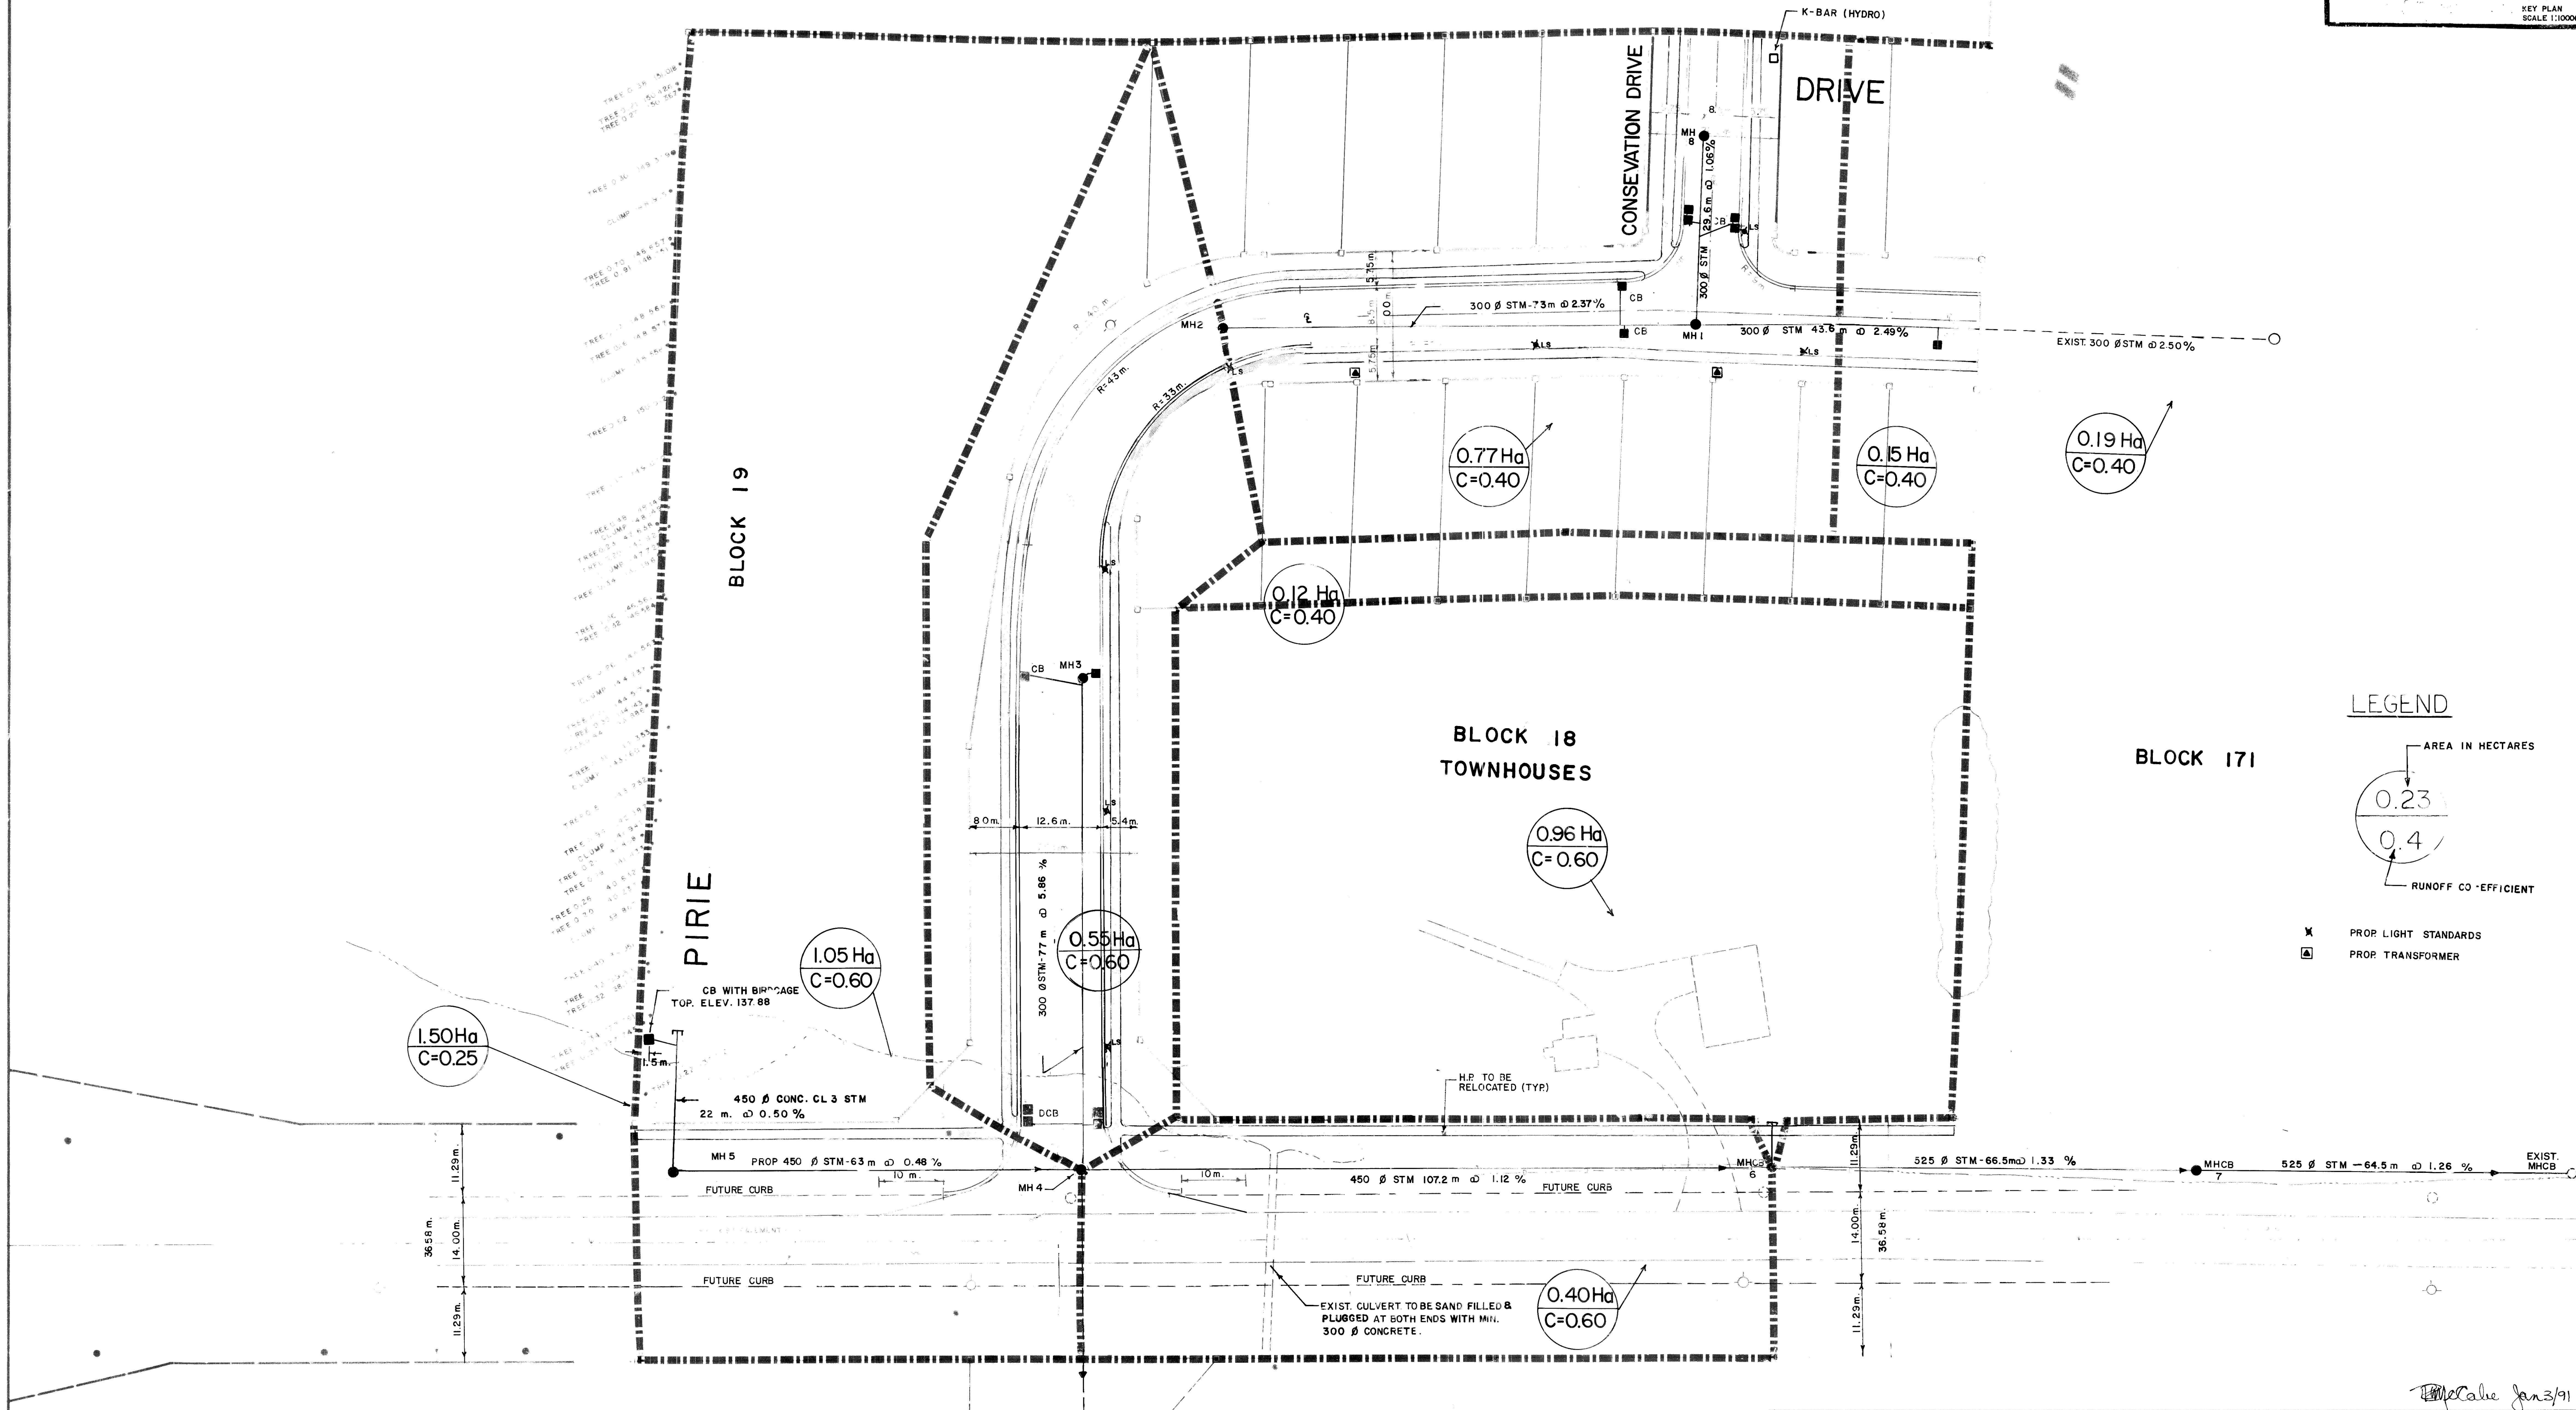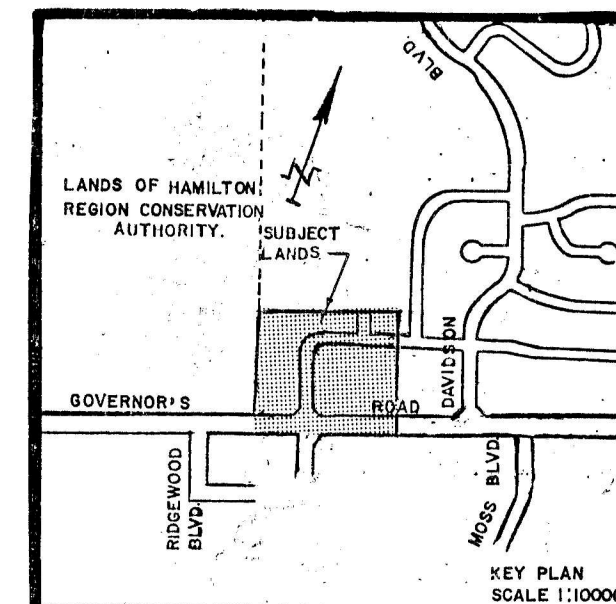

**LEGEND**

○ AREA IN HECTARES

○ 0.23

○ 0.4

○ RUNOFF CO-EFFICIENT

✕ PROP LIGHT STANDARDS

▣ PROP TRANSFORMER

GOVERNOR'S ROAD  
(HIGHWAY 99)

Nº	BY	DATE	REVISIONS
3	H.O.	DEC. 90	NOTE ON 750 Ø CMP
2	H.O.	SEPT. 90	HYDRO INFO. ADDED PER TOWN'S COMMENTS
1	H.O.	JUNE 90	AS PER TOWN'S & REGION'S COMMENTS

**SIDNEY W. WOODS**  
ENGINEERING INC. HAMILTON, ONTARIO

**TOWN OF DUNDAS**

**ROBINSON HOMES LTD.**

**CONSERVATION RUN**  
(PHASE - ONE)  
STORM AREA PLAN

DATE: JAN 3 1991

SCALE: 1:1000

SHEET: STM